


015795 2011 PZDB-B-11081

Zienswijze dijkversterking haven Walsoorden



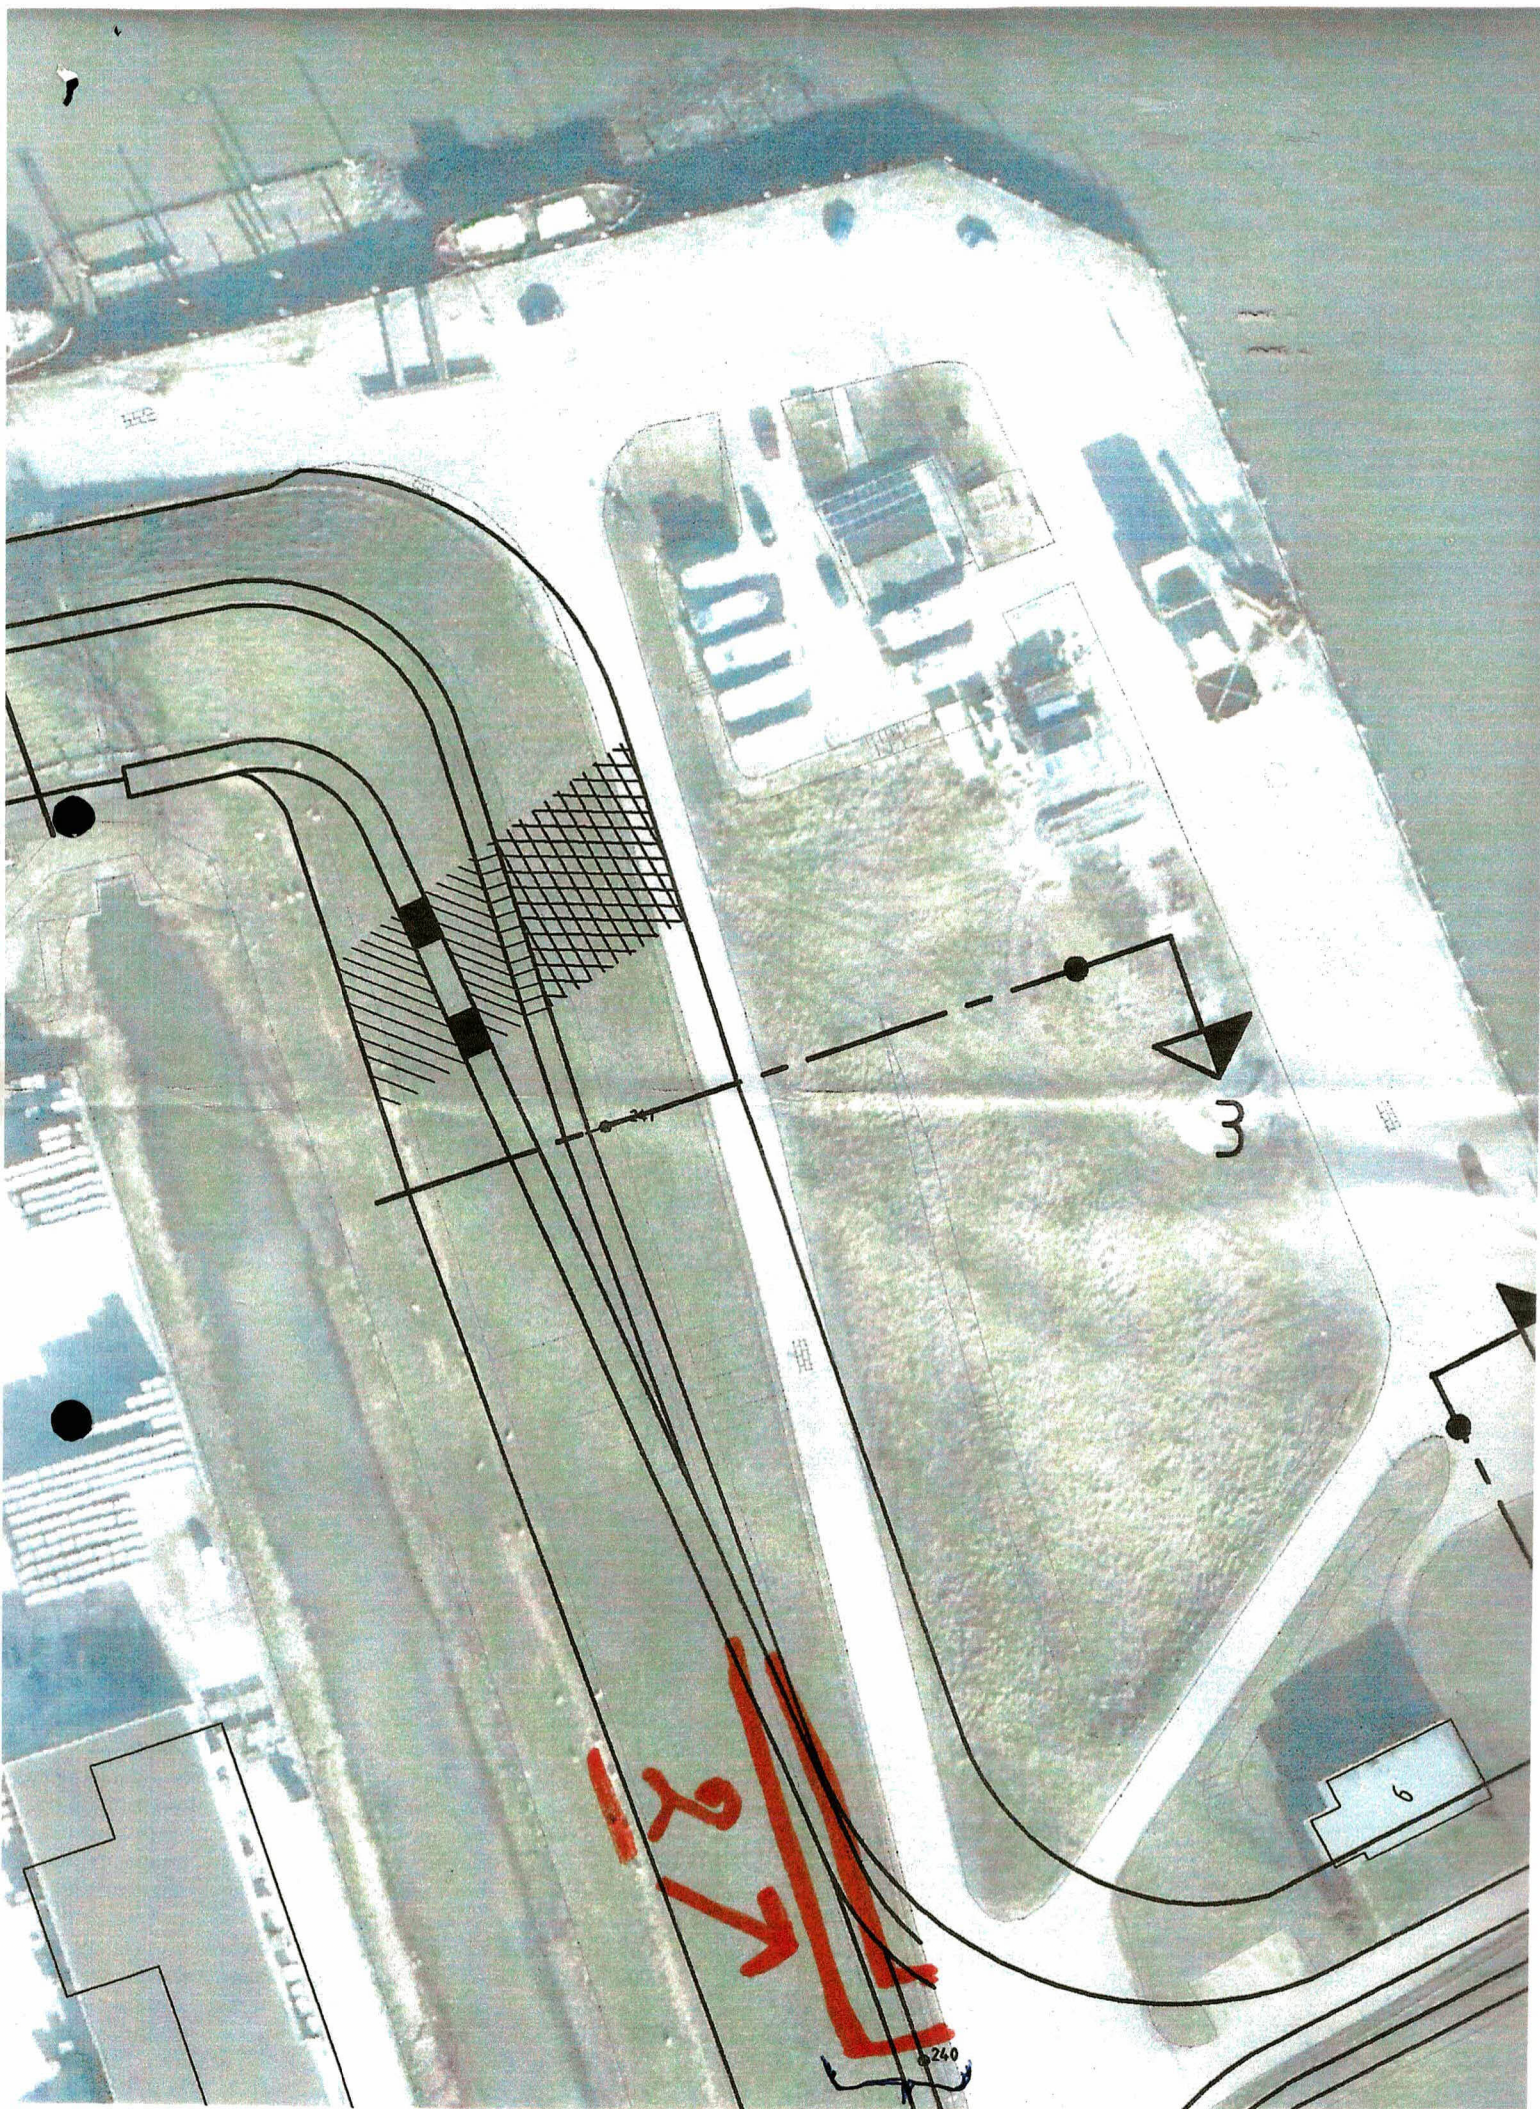



50 10m.



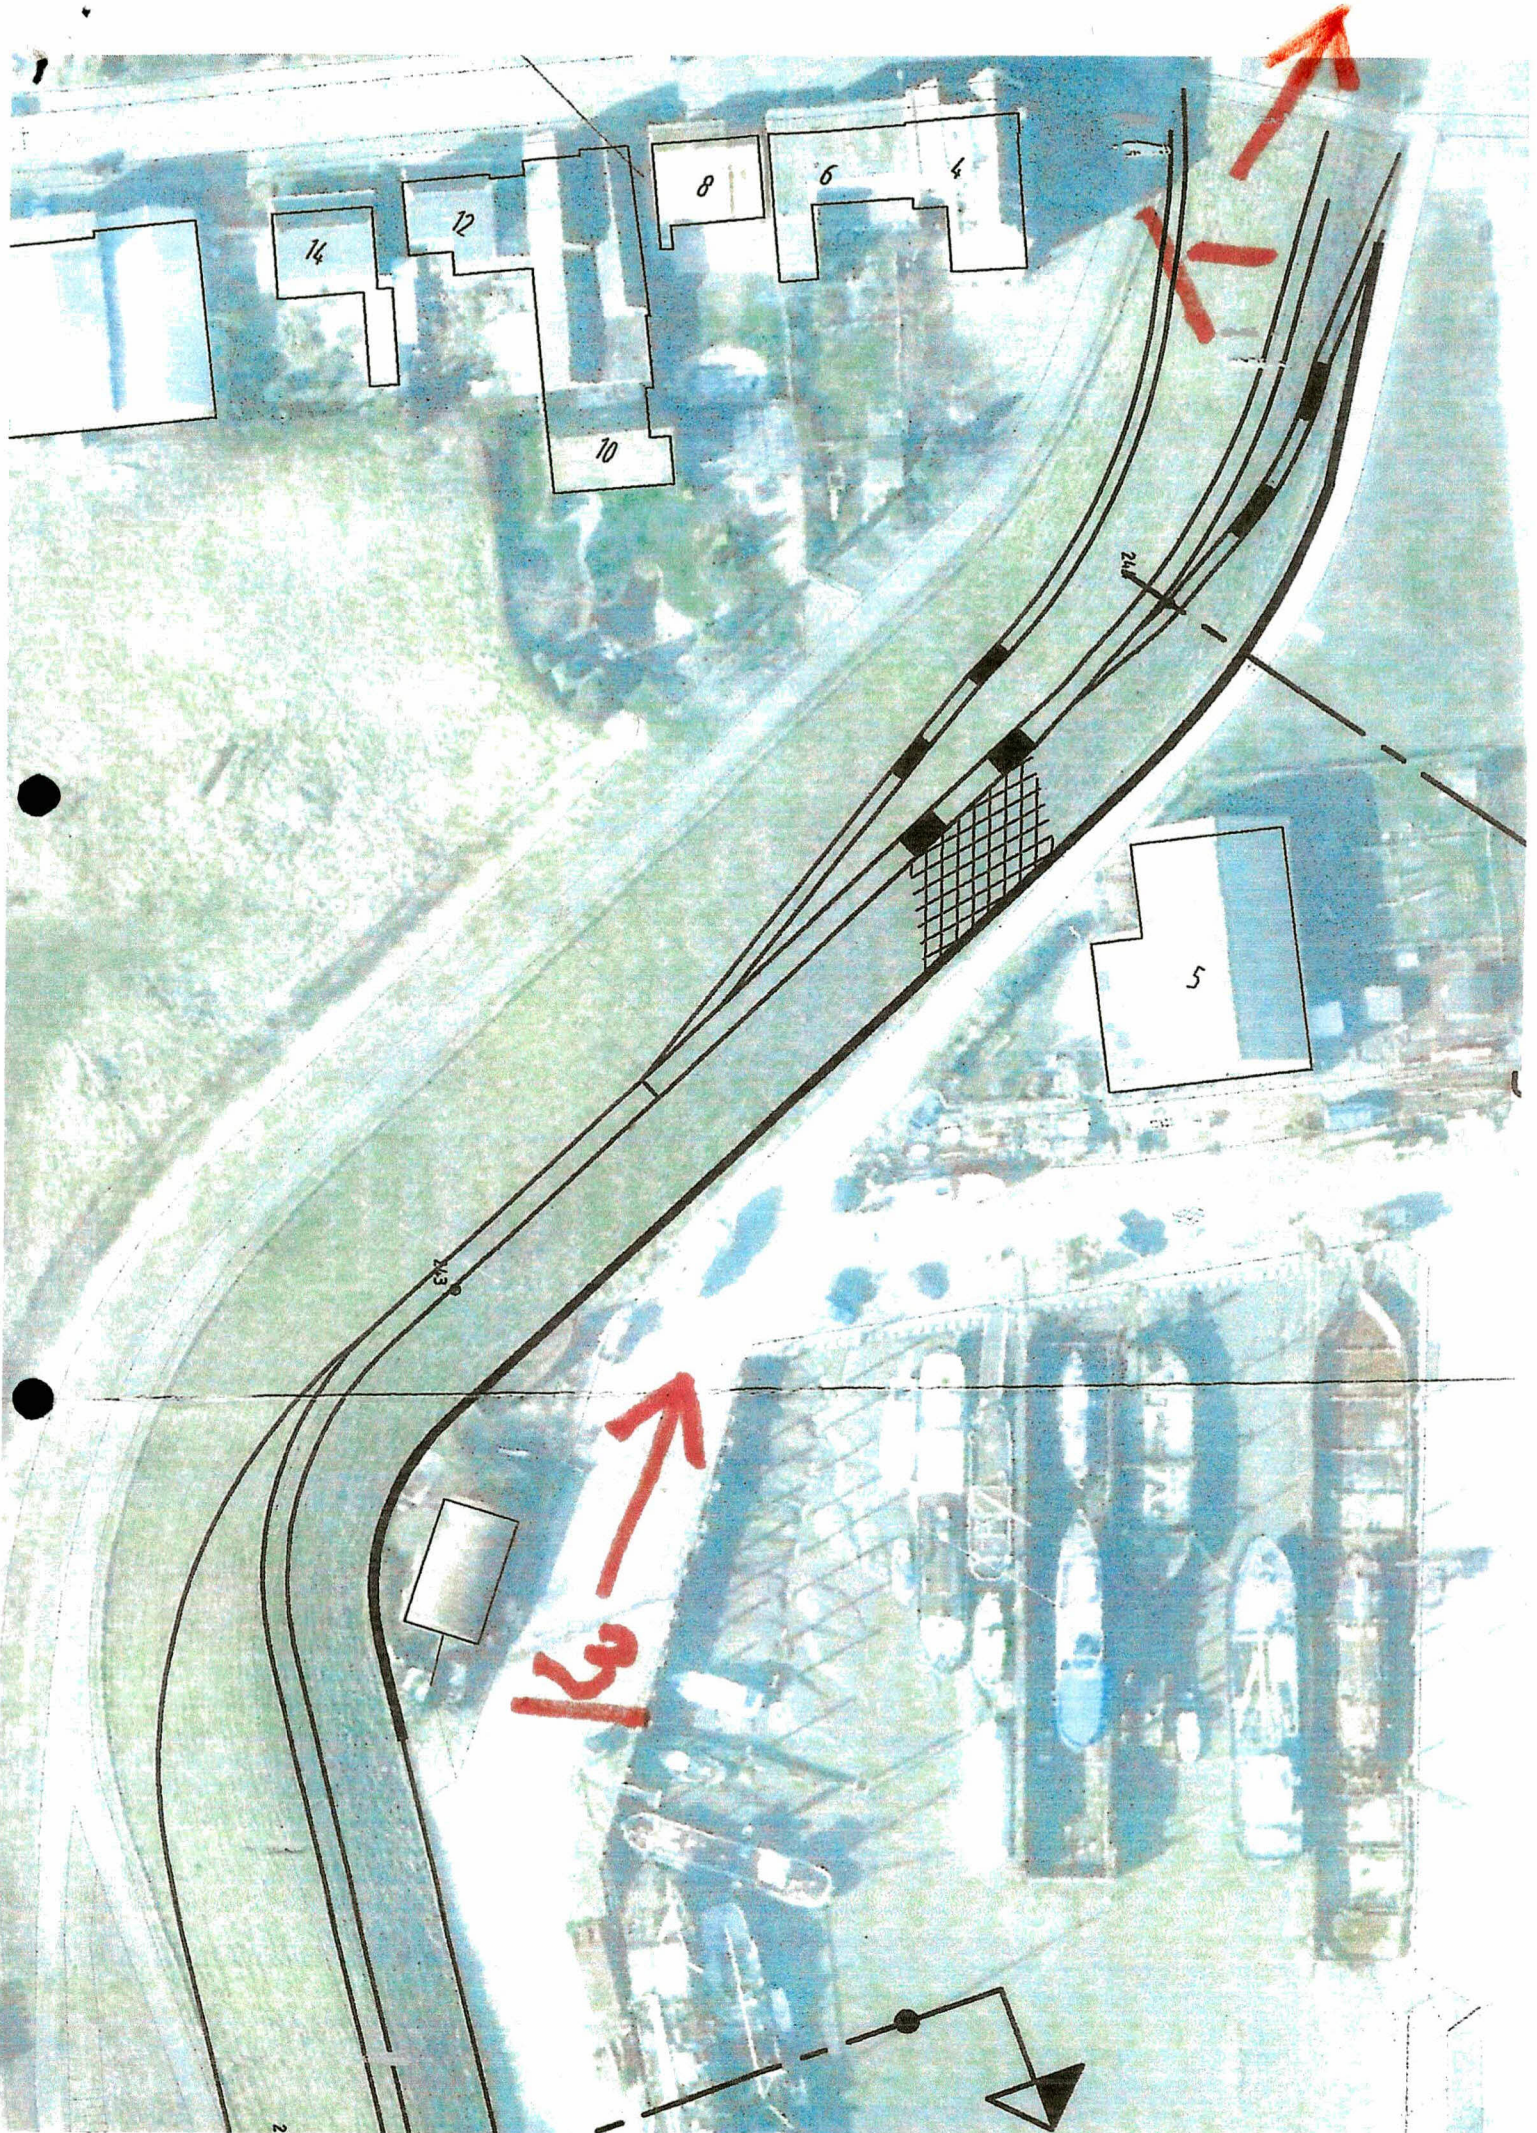

14

12

10

8

6

4

5

31

24

13

2